


OKLAHOMA CERTIFIED CORNER RECORD

Existing X Obliterated _____ Lost _____

C.M. Document No. _____

NW Corner of Section 5 Township 1 North Range 11 West

Meridian I.M. County Comanche

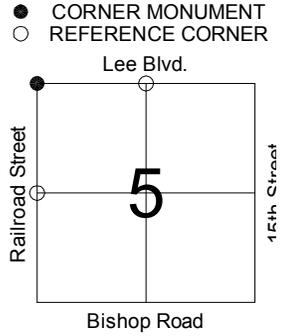

DESCRIPTION OF ORIGINAL MONUMENT AND ACCESSORIES AND ANY SUBSEQUENT RESTORATION: (Give Sources of Information)

Sand Stone 5x8x6
Department of Libraries GLO Notes.

MONUMENT DESCRIPTION:

Description of Corner Evidence Found:

No evidence of PK Nail
All ties from Phillips Stevenson CCR were in place and undisturbed

Coordinates established using classical static GPS, minimum two independent vectors
Included in the HPGN adjustment of 1993

Description of Corner Evidence Set:

Set 3" Mag Nail based on CCR by Phillip Stevenson, June 12, 1986
CCR from 1986 called for PK nail set based on survey by Ernie Morales on Nov20, 1985


REFERENCE MEASUREMENTS: (At Least Three)

Description:	Distance	Bearing
	Feet	True <input type="checkbox"/> Magnetic <input checked="" type="checkbox"/>
RP # 1 Top Fire Hydrant "American Darling"	68.28'	No Declinator S 9° 35' W
RP # 2 60d in Power Pole	67.52'	S 20° 00' W
RP # 3 60d in Power Pole	119.65'	N 11° 46' W
RP # 4 Chiseled 'X' in Headwall	78.87	N 71° 58' E
RP # 5 Chiseled 'X' in Headwall	114.09'	S 39° 44' E

SC # 1 N 1/4 Corner "X" in Concrete	Ground Dist.: 2640.21'	Grid Dist.: 2639.91'	Grid Bearing: S 89°34'31" E
SC # 2 W 1/4 Corner 1/2" IP	Ground Dist.: 2641.73'	Grid Dist.: 2641.44'	Grid Bearing: S 00°11'20" E

STATEMENT OF METHOD USED TO DETERMINE CORNER LOCATION: (Lost Corners Only)

SKETCH:

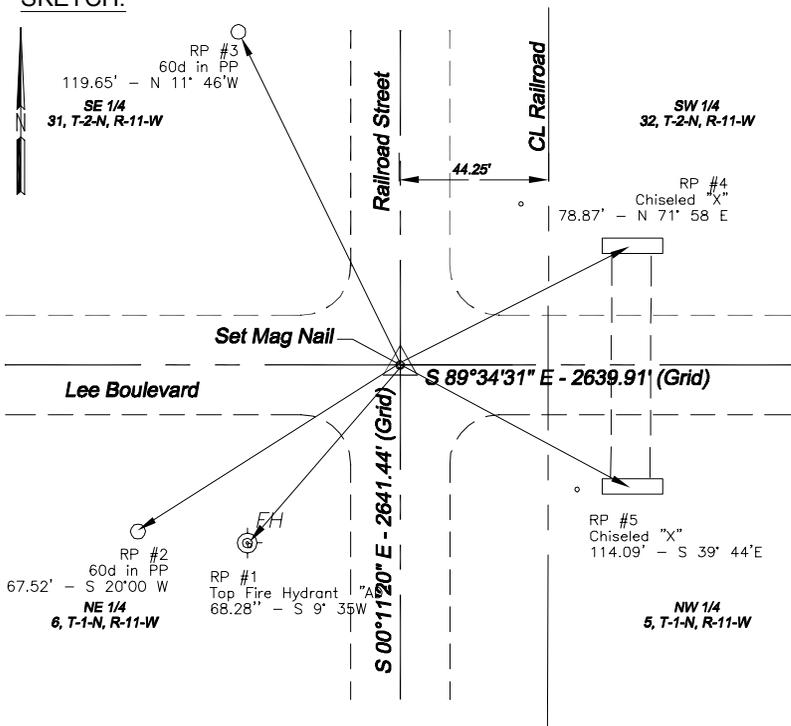

SURVEYOR'S CERTIFICATION: This is to certify that the monuments and accessories indicated above are correctly described and shown. I further certify that the corner records were checked for any filings prior to making this survey.


Signature: Edward Deral Paulk, Jr
City Of Lawton, Engineering Department
Firm _____ Phone Number _____
103 SW 4th Street (580) 581-3318
Street Address/Post Office Box _____
Lawton, Oklahoma 73501
City, State and Zip Code _____
14 August 2003 P.L.S. 1279
Date and Registration Number _____

OKLAHOMA STATE PLANE COORDINATES: NAD 1983 (ADJ 1993 HARN)
Coordinates are in US Survey Feet.

X: E 1851920.461 Y: N 459112.920 ZONE: SOUTH

Accepted and Filed: _____
Archivist, Archives & Records Division
Oklahoma Department of Libraries
200 Northeast 18th Street
Oklahoma City, Oklahoma 73105

Date: _____

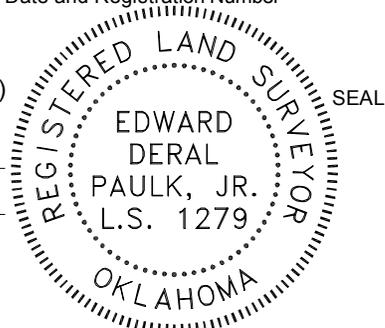

File Name: 56S5.dwg