


OKLAHOMA CERTIFIED CORNER RECORD

X Existing _____ Obliterated _____ Lost

C.M. Document No. _____

S1/4 Corner of Section 22 Township 2 North Range 12 West

Meridian I.M. County Comanche

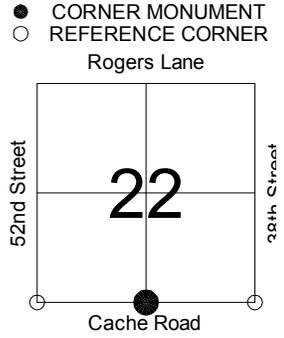

DESCRIPTION OF ORIGINAL MONUMENT AND ACCESSORIES AND ANY SUBSEQUENT RESTORATION: (Give Sources of Information)

Set Sandstone 16 x 12 x 5
Department of Libraries GLO Notes.

MONUMENT DESCRIPTION:

Description of Corner Evidence Found:

Found 1/2" Iron Pin in grass median 0.5' North of back of curb.
Matches ties from CCR filed by Phil Stevenson, LS 1159, dated 5 February 1987.

Description of Corner Evidence Set:

None, Corner Existing
Ties added to SE Corner and SW Corner of Section 22
Coordinates established using classical static GPS, minimum two independent vectors


REFERENCE MEASUREMENTS: (At Least Three)

Description:	Distance	Bearing
	Feet	True <input type="checkbox"/> Magnetic <input checked="" type="checkbox"/>
RP # 1 Center of Water Valve in concrete pavement	60.90'	No Declination
RP # 2 "X" on top of curb at P.C. of curve	93.16'	S 15°20' E
RP # 3 "X" on SE corner of Concrete Base for Light Pole	97.19'	S 51°37' W
RP # 4 Top of Fire Hydrant	97.42'	N 85°19' W
RP # 5 "X" on SW corner of Concrete Base for Light Pole	101.86'	N 39°55'35" W
		N 86°50' E

SC #1 SW Corner Found Large Spike	Ground Dist.: 2618.61'	Grid Dist.: 2618.30'	Grid Bearing: S 89°58'44" W
SC #2 SE Corner Found ODOT C-16-162	Ground Dist.: 2628.74'	Grid Dist.: 2628.44'	Grid Bearing: N 89°56'05" E

STATEMENT OF METHOD USED TO DETERMINE CORNER LOCATION: (Lost Corners Only)

SKETCH:

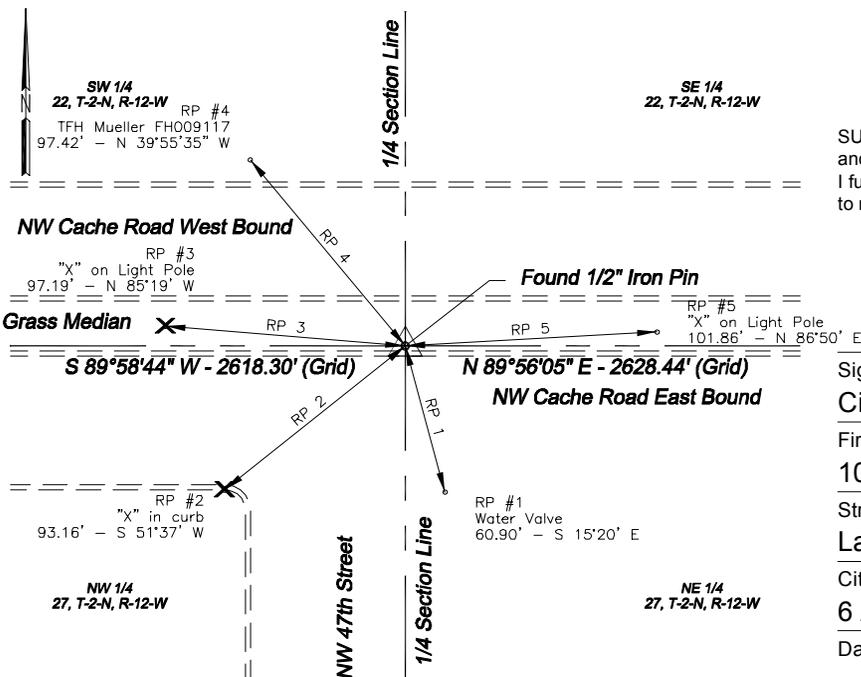

SURVEYOR'S CERTIFICATION: This is to certify that the monuments and accessories indicated above are correctly described and shown. I further certify that the corner records were checked for any filings prior to making this survey.

Signature Michael D. Porter, PLS 1514
City Of Lawton, Engineering Department
Firm _____ Phone Number _____
103 SW 4th Street (580) 581-3318
Street Address/Post Office Box _____
Lawton, Oklahoma 73501
City, State and Zip Code _____
6 August 2003 P.L.S. 1514
Date and Registration Number _____

OKLAHOMA STATE PLANE COORDINATES: NAD 1983 (ADJ 1993 HARN)
Coordinates are in US Survey Feet.

X: E 1833566.143 Y: N 469800.004 ZONE: SOUTH

Accepted and Filed: _____
Archivist, Archives & Records Division
Oklahoma Department of Libraries
200 Northeast 18th Street
Oklahoma City, Oklahoma 73105

