


OKLAHOMA CERTIFIED CORNER RECORD

X Existing _____ Obliterated _____ Lost

C.M. Document No. _____

SE Corner of Section 22 Township 2 North Range 12 West

Meridian I.M. County Comanche

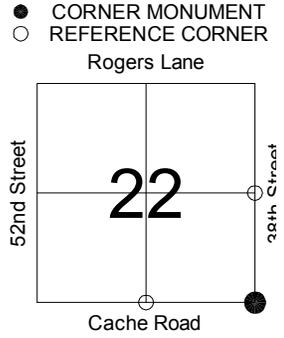

DESCRIPTION OF ORIGINAL MONUMENT AND ACCESSORIES AND ANY SUBSEQUENT RESTORATION: (Give Sources of Information)

Set Sandstone 15 x 13 x 5 On Original Survey
Department of Libraries GLO Notes.

MONUMENT DESCRIPTION:

Description of Corner Evidence Found:

Found ODOT Brass Cap C-16-162 Form 11 Dewayne Walden 1971
ODOT set on project 2811(1)

Matches ties from CCR filed by Phil Stevenson, LS 1159, Dated 5 February 1987.

Multiple projects in City of Lawton have honored this cap

Description of Corner Evidence Set:

None, Corner Existing

Ties added to South 1/4 Corner and East 1/4 Corner

Coordinates established using classical static GPS, minimum two independent vectors


REFERENCE MEASUREMENTS: (At Least Three)

Description:	Distance	Bearing
	Feet	True <input type="checkbox"/> Magnetic <input checked="" type="checkbox"/>
RP # 1 Center of Sanitary Sewer Manhole	42.71'	No Declination
RP # 2 Top of Fire Hydrant (Dresser FH027103)	84.86'	S 77°59' E
RP # 3 "X" on North side of Concrete Base for Light Pole	91.65'	S 28°04' E
RP # 4 "X" on East side of Concrete Base of Signal Light	71.98'	S 34°59' W
RP # 5 "X" on East side of Concrete Base of Signal Light	82.71'	N 83°55' W

SC # 1 E 1/4 Found PK Nail	Ground Dist.: 2658.62'	Grid Dist.: 2658.31'	Grid Bearing: N 00°16'59" E
SC # 2 S 1/4 Found 1/2" Iron Pin	Ground Dist.: 2628.74'	Grid Dist.: 2628.44'	Grid Bearing: S 89°56'05" W

STATEMENT OF METHOD USED TO DETERMINE CORNER LOCATION: (Lost Corners Only)

SKETCH:

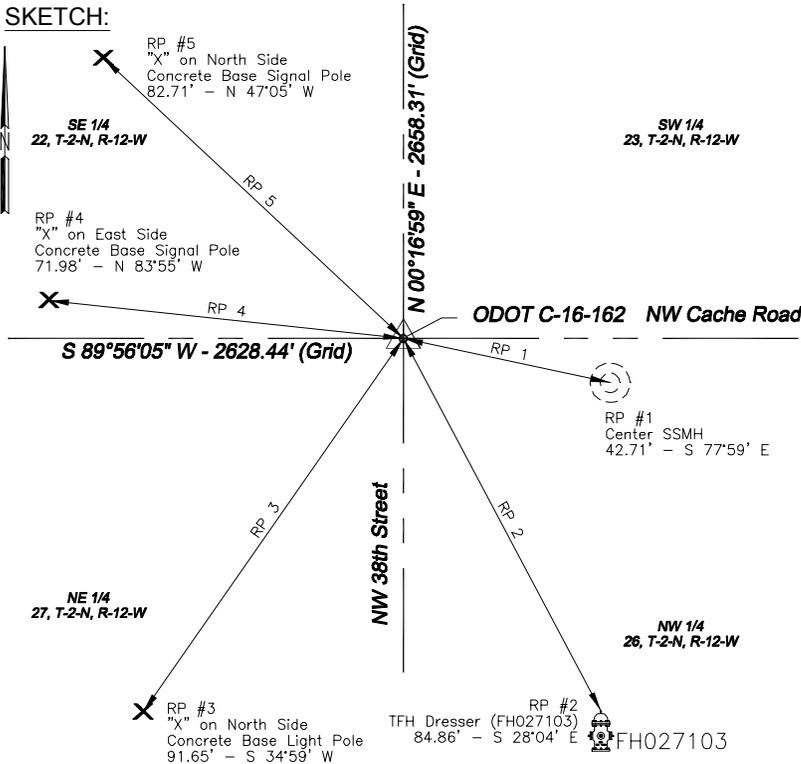

SURVEYOR'S CERTIFICATION: This is to certify that the monuments and accessories indicated above are correctly described and shown. I further certify that the corner records were checked for any filings prior to making this survey.

Signature Michael D. Porter, PLS 1514
 City of Lawton, Engineering Department
 Firm Phone Number
 103 SW 4th Street (580) 581-3318
 Street Address/Post Office Box
 Lawton, Oklahoma 73501
 City, State and Zip Code
 6 August 2003 P.L.S. 1514
 Date and Registration Number

OKLAHOMA STATE PLANE COORDINATES: NAD 1983 (ADJ 1993 HARN)
Coordinates are in US Survey Feet.

X: E 1836194.575 Y: N 469803.004 ZONE: SOUTH

Accepted and Filed: _____
 Archivist, Archives & Records Division
 Oklahoma Department of Libraries
 200 Northeast 18th Street
 Oklahoma City, Oklahoma 73105

Date: _____ File Name: C-16-162-09S1.dwg

